





SOUTH PARK AVENUE (WIDTH VARIES)
US RTE 62
(DEDICATED PUBLIC HIGHWAY)

DATE	REVISION/TITLE
11/13/24	ALTA SURVEY
10/10/24	RESURVEY
12/09/22	AS-BUILT SURVEY
07/01/19	REVISE PARCEL BOUNDARY

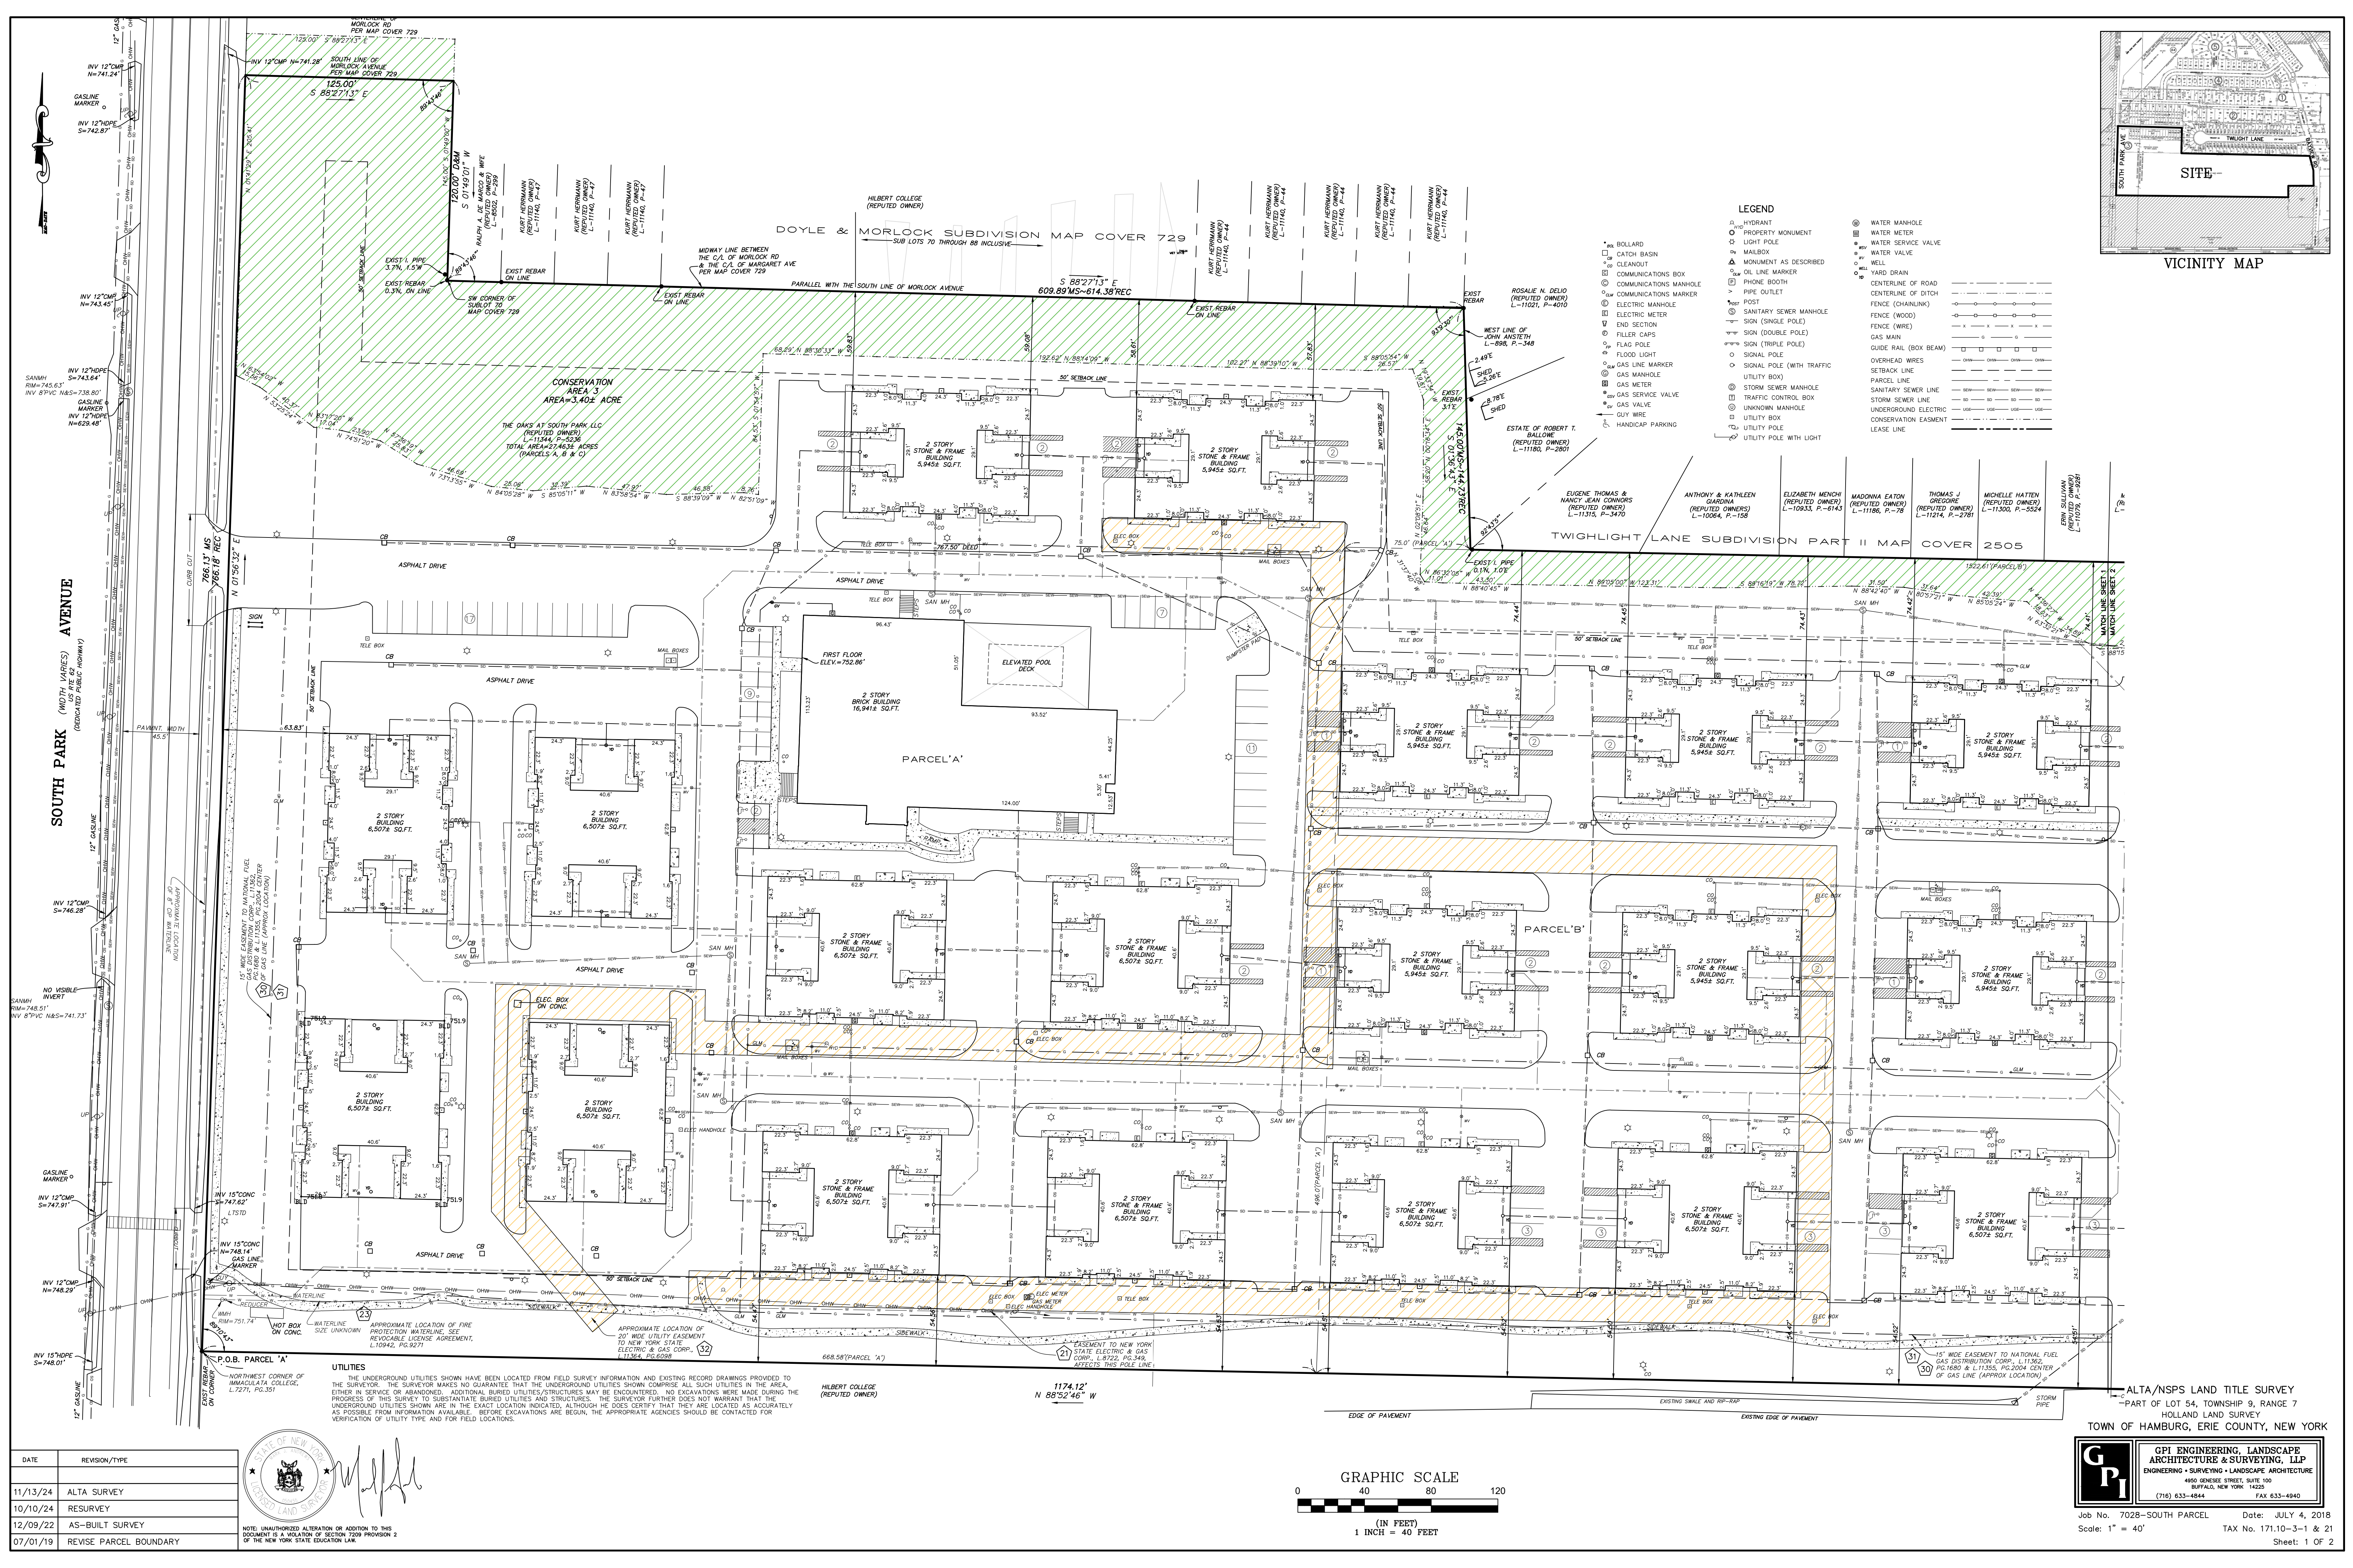

STATE OF NEW YORK
COUNTY OF ERIE
TOWN OF HAMBURG

NOTE: UNAUTHORIZED ALTERATION OR ADDITION TO THIS DOCUMENT IS A VIOLATION OF SECTION 2209 PROVISION 2 OF THE NEW YORK STATE EDUCATION LAW.

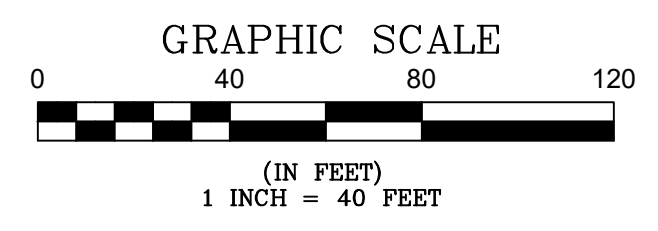



GPI ENGINEERING, LANDSCAPE ARCHITECTURE & SURVEYING, LLP
ENGINEERING • SURVEYING • LANDSCAPE ARCHITECTURE
4850 GENESEE STREET, SUITE 100
BUFFALO, NEW YORK 14225
(716) 633-4844 FAX 633-4840

Job No. 7028-SOUTH PARCEL Date: JULY 4, 2018
Scale: 1" = 40' TOWN OF HAMBURG, ERIE COUNTY, NEW YORK
PART OF LOT 54, TOWNSHIP 9, RANGE 7
HOLLAND LAND SURVEY
ALTA/NSPS LAND TITLE SURVEY
-PART OF LOT 54, TOWNSHIP 9, RANGE 7
HOLLAND LAND SURVEY